

OFFICE OF THE MARION COUNTY SURVEYOR

SECTION RECORD CORNER

SECTION 21 TOWNSHIP 16 RANGE 5

DATE: 3-2-06

PARTY CHIEF: Wilcoxon

CREW: _____

TYPE OF MARKER: Copperweld fd 1" down

METHOD OF ESTABLISHMENT: County: 9-16-01


IN. S.P.C. E ZONE NAD '83

NAME: 16052101

N: 508279.4670(m)

E: 72228.9100(m)

Note: Ties and calculation sheets from
Schneider Eng. (See notes on file in MCS0).

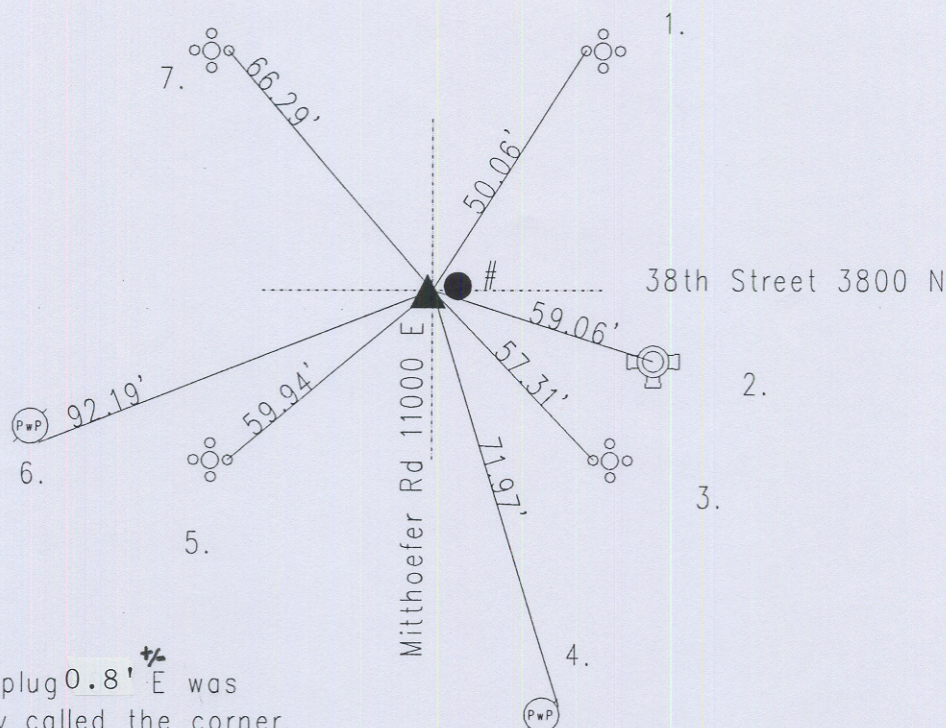

brass plug 0.8' E was
previously called the corner.
No brass found this tie sheet.

16052101

REF.	DISTANCE	DESCRIPTION
1.	50.06'	Cut 'x' W bolt of aluminum pole base
2.	59.06'	Top nut of fire hydrant
3.	57.31'	Cut 'x' W bolt of aluminum pole base
4.	71.97'	PK nail NF PwP#14-421CB 6"up
5.	54.94'	Cut 'x' E bolt of aluminum pole base
6.	92.19'	PK nail SF PwP#87-421BB 12"up
7.	66.29'	Cut 'x' E bolt of aluminum pole base